LEGEND:

RADIATOR

LIGHT FITTING

E

EMERGENCY LIGHT FITTING

COMMON PARTS EMERGENCY LIGHT

S SMOKE DETECTOR

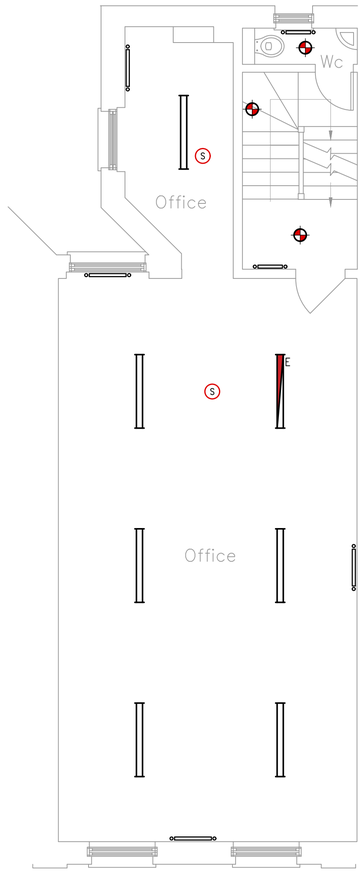

Rev	Date	Description	By

SAMAC
Samac House, Metro Centre, Bridge Road, Orpington, Kent BR5 2BJ
t: 08700 844448 f: 08700 844447
www.samacconstruction.co.uk

Drg. Status
AS BUILT

Client

Project
11 MADDOX STREET
MAYFAIR
LONDON W15 2QF

Drawing Title
AS BUILT PLANS
THIRD FLOOR

Drawn	Date
N.T.	MARCH 2017
Scale	Checked
1:50 @ A1	J.E.

Drawing Number
A26383/04

Rev